
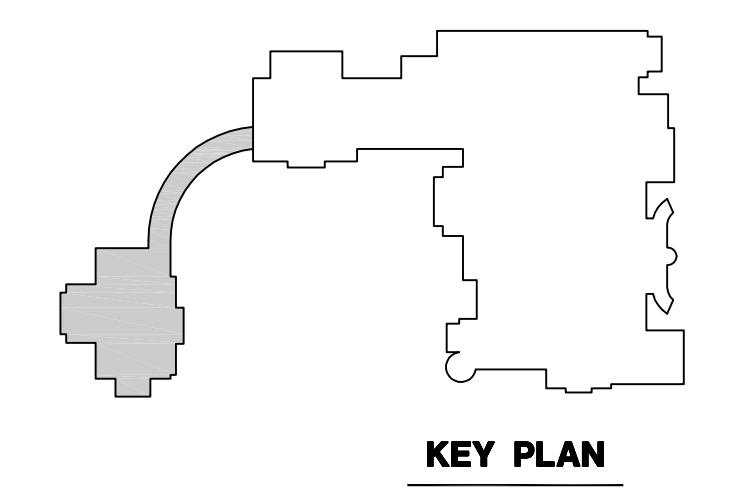
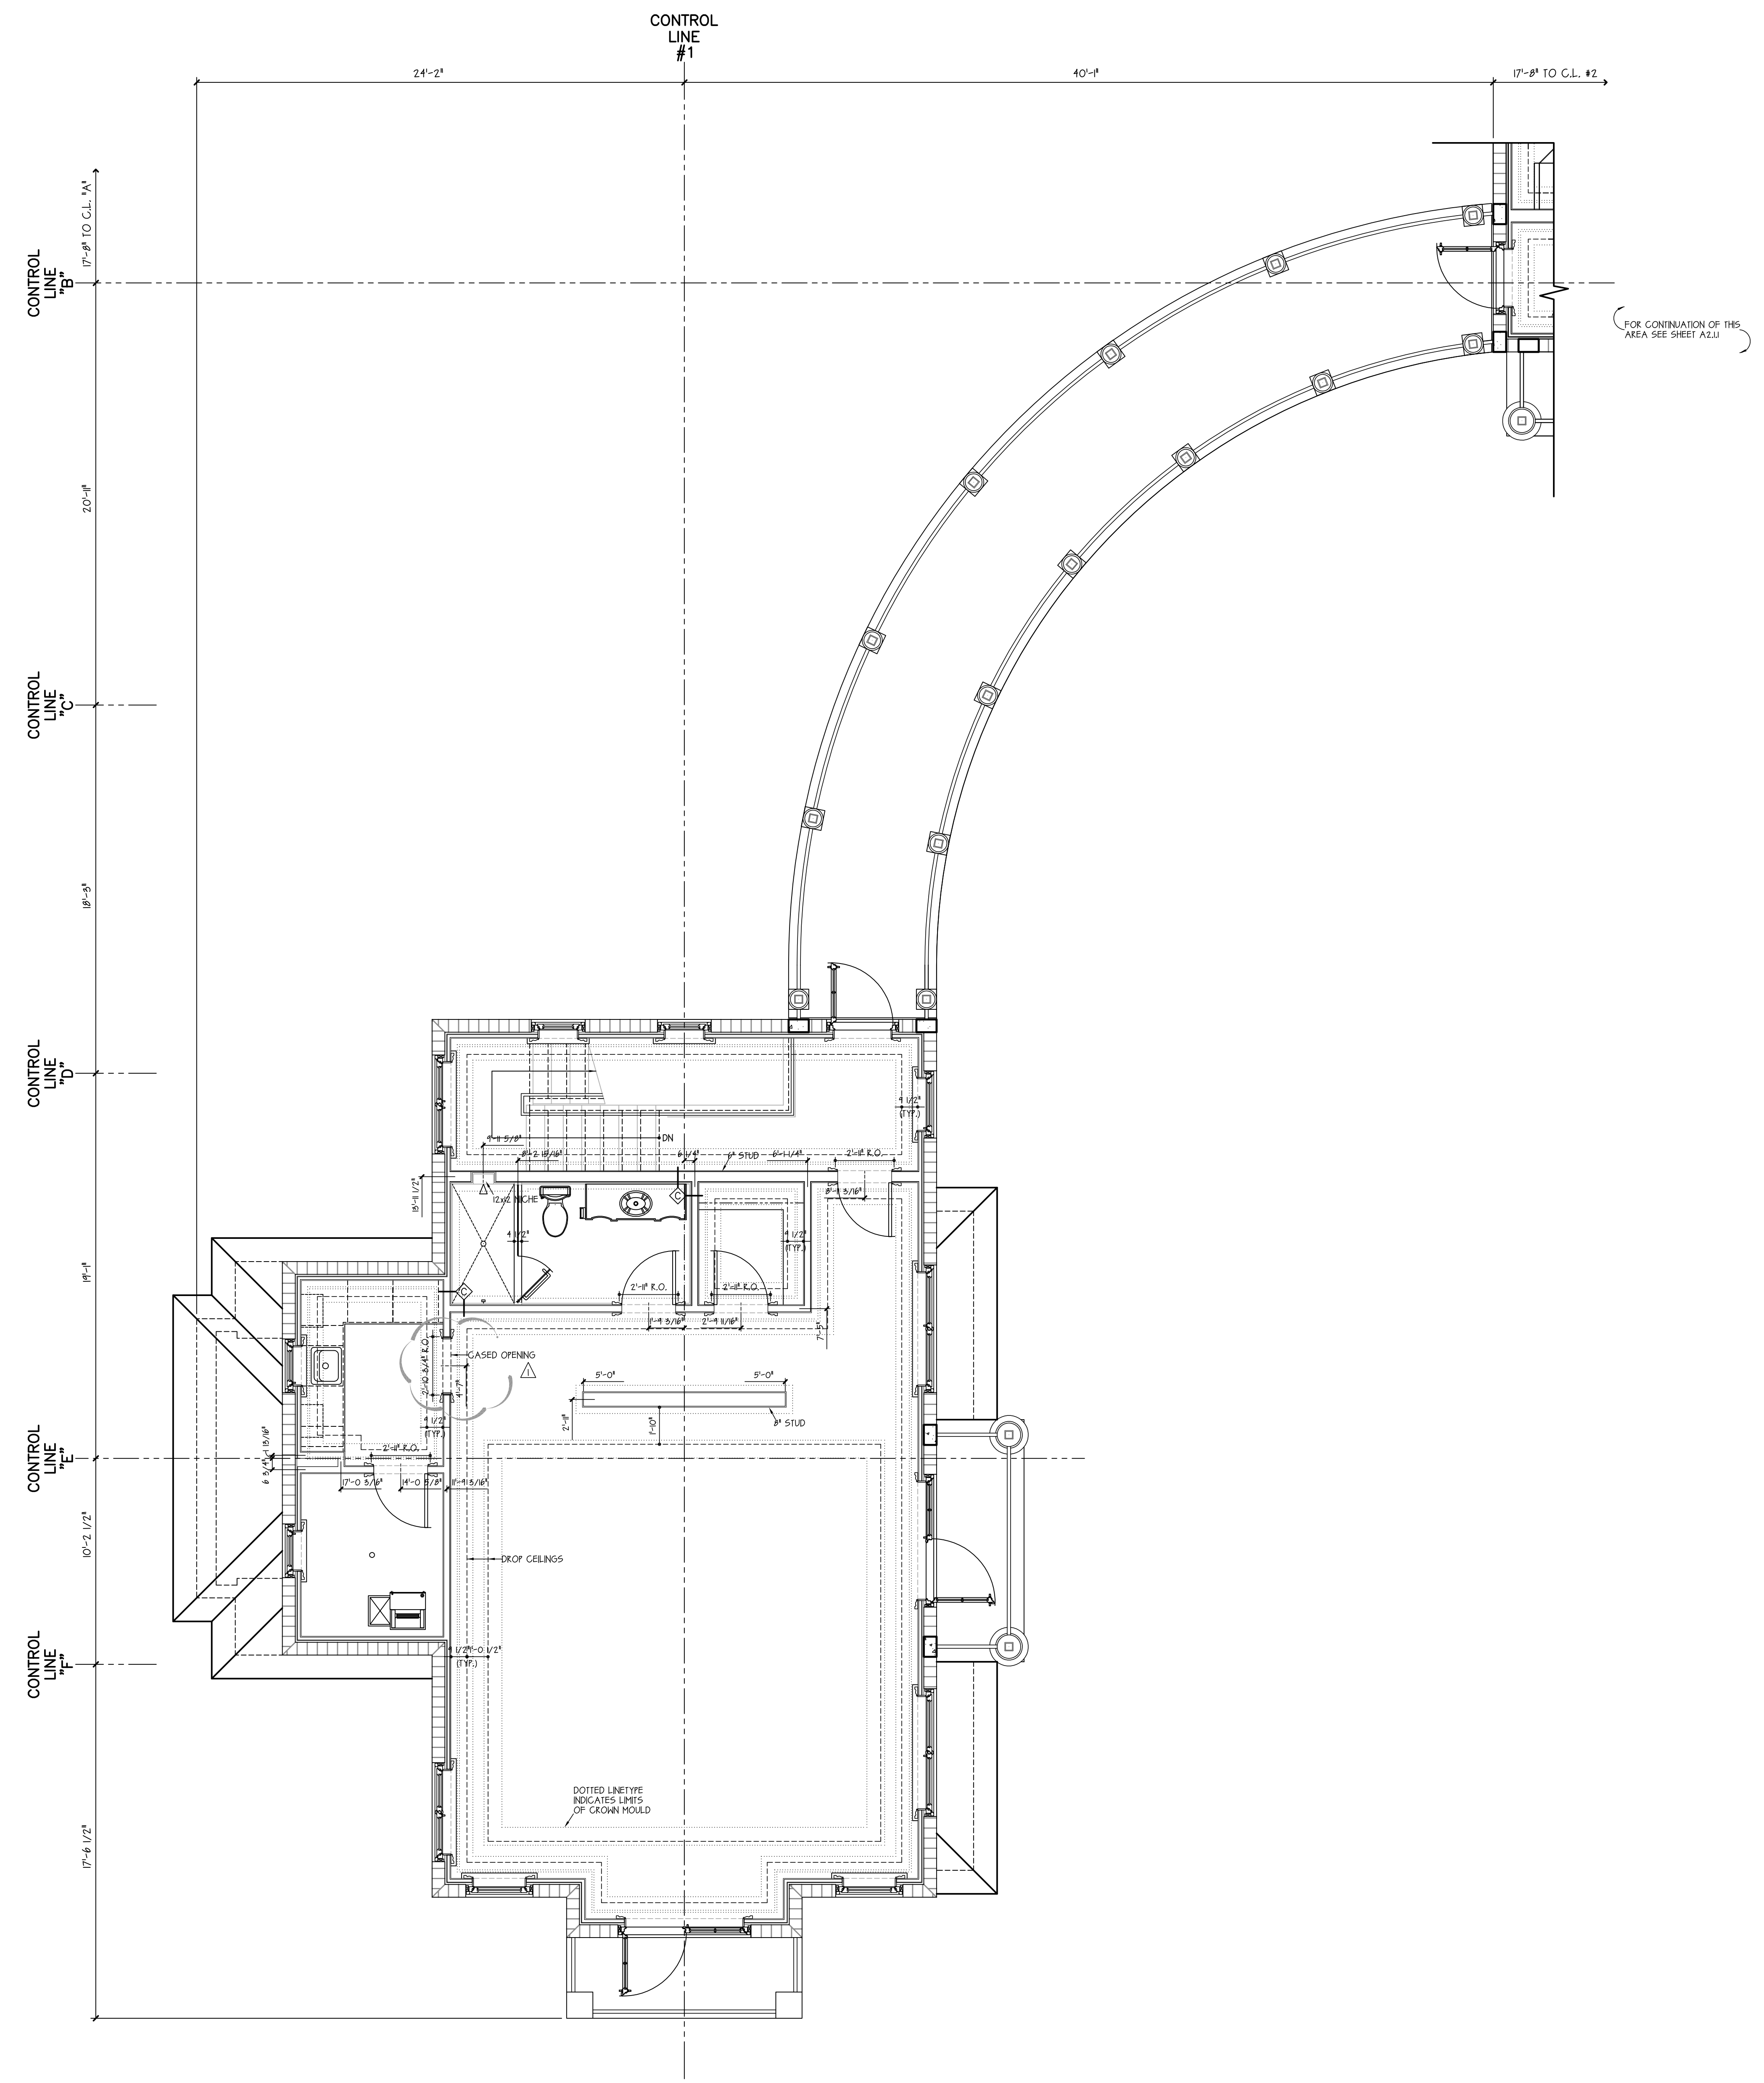
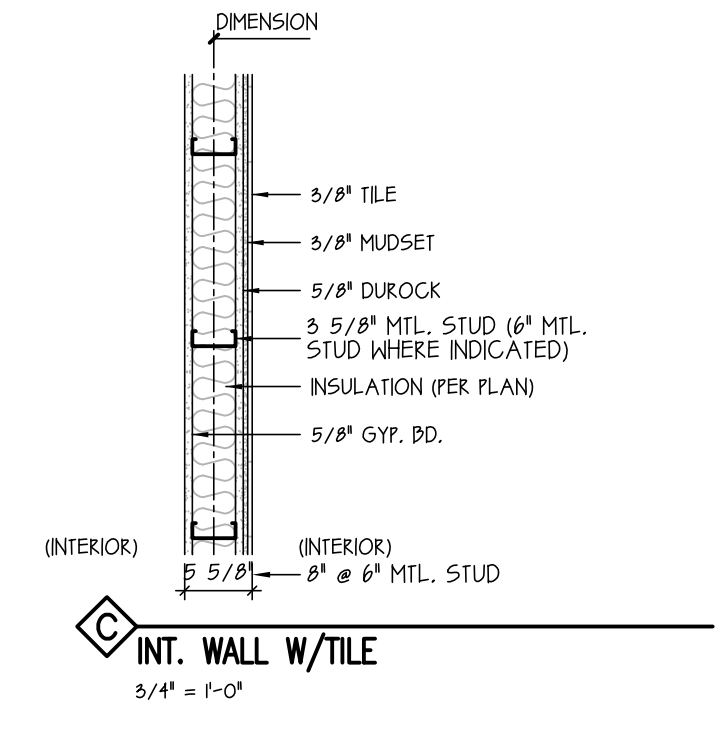
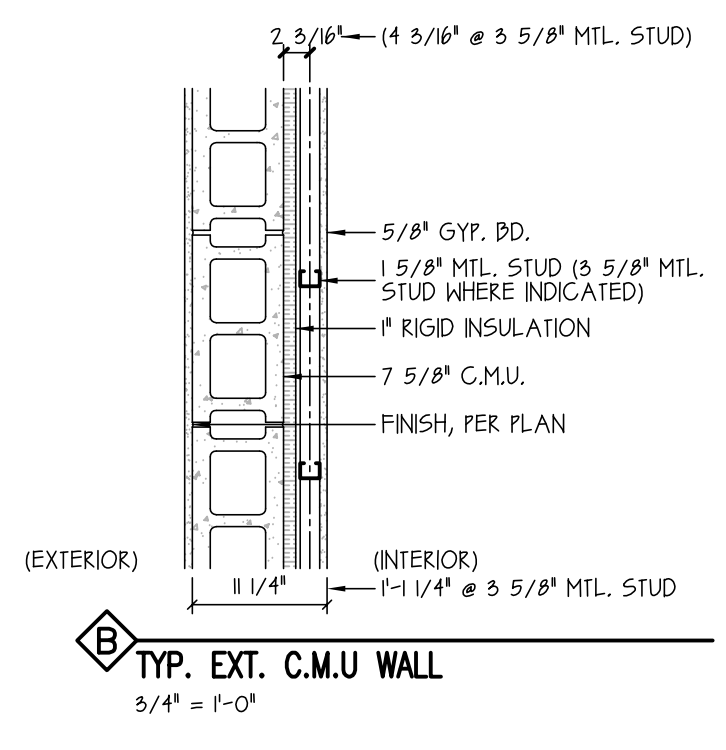


NOTES:  
 ALL DIMENSIONS SHOWN ARE FROM CENTERLINE OF STUD, CENTERLINE OF INTERSECTION OF STUDS (SUCH AS AT ANGLED WALLS), END OF STUD (NOT DRYWALL), CENTERLINE OF DOOR & WINDOW OPENINGS, OR CENTERLINE OF VARIOUS ELECTRICAL BOX TO CONTROL LINES (UNO.).  
 ALL "CEILING DECK" DIMENSIONS ARE ACTUAL, FINISH TO FINISH.  
 ALL INT. WALLS TO BE TYPE "A" (TY, UNO.).  
 ALL EXT. WALLS TO BE TYPE "B" (TY, UNO.).  
 SEE THIS SHEET FOR WALL TYPE LEGEND.  
 REFER TO ARCHITECT OF RECORD PLANS FOR ADDITIONAL NOTES.

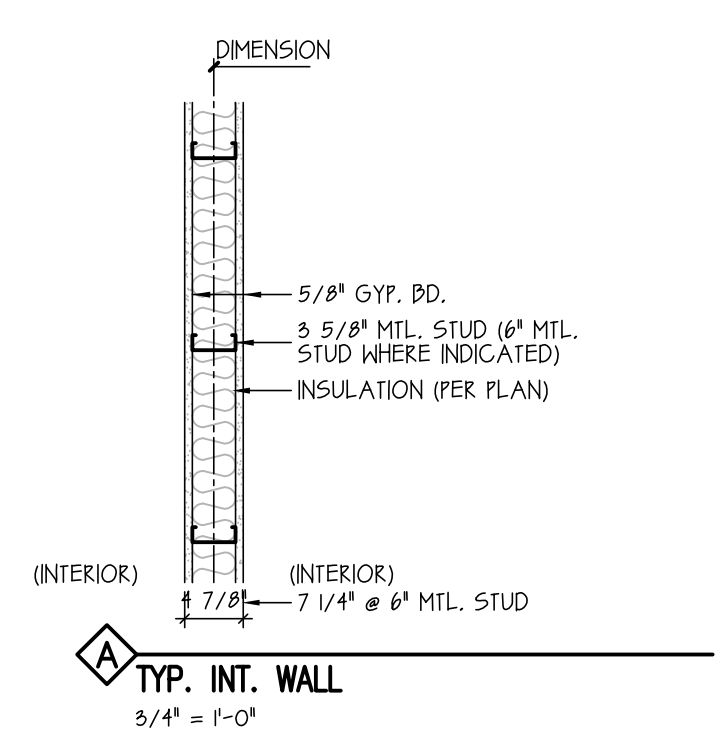

NO.	REVISIONS:	DATE
1	ISSUED FOR FIELD USE	04/27/20
2	SEE CLOURED AREAS	04/28/20

**SCALE:**  
**1/4"=1'-0"**

**SHEET NO.:**  
**A2.12**