
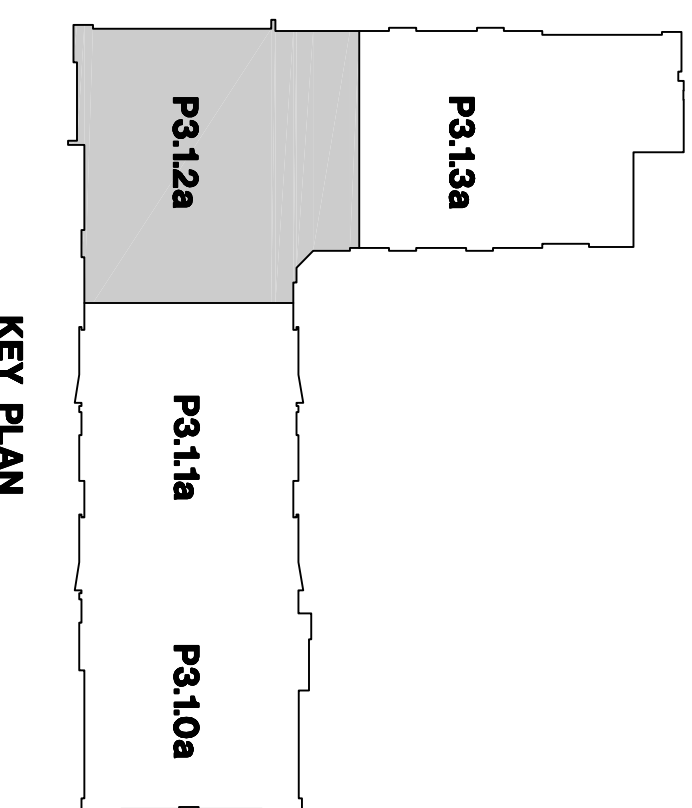


NOTES:  
 1. ALL DIMENSIONS SHOWN SHALL BE FROM CENTERLINE OF THE CONTROL LINE OF GENERAL OR FROM FACE OF CONTROL LINE TO CONTROL LINE.  
 2. REFER TO PROJECT OF RECORD PLANS FOR DIMENSIONS NOT SHOWN.

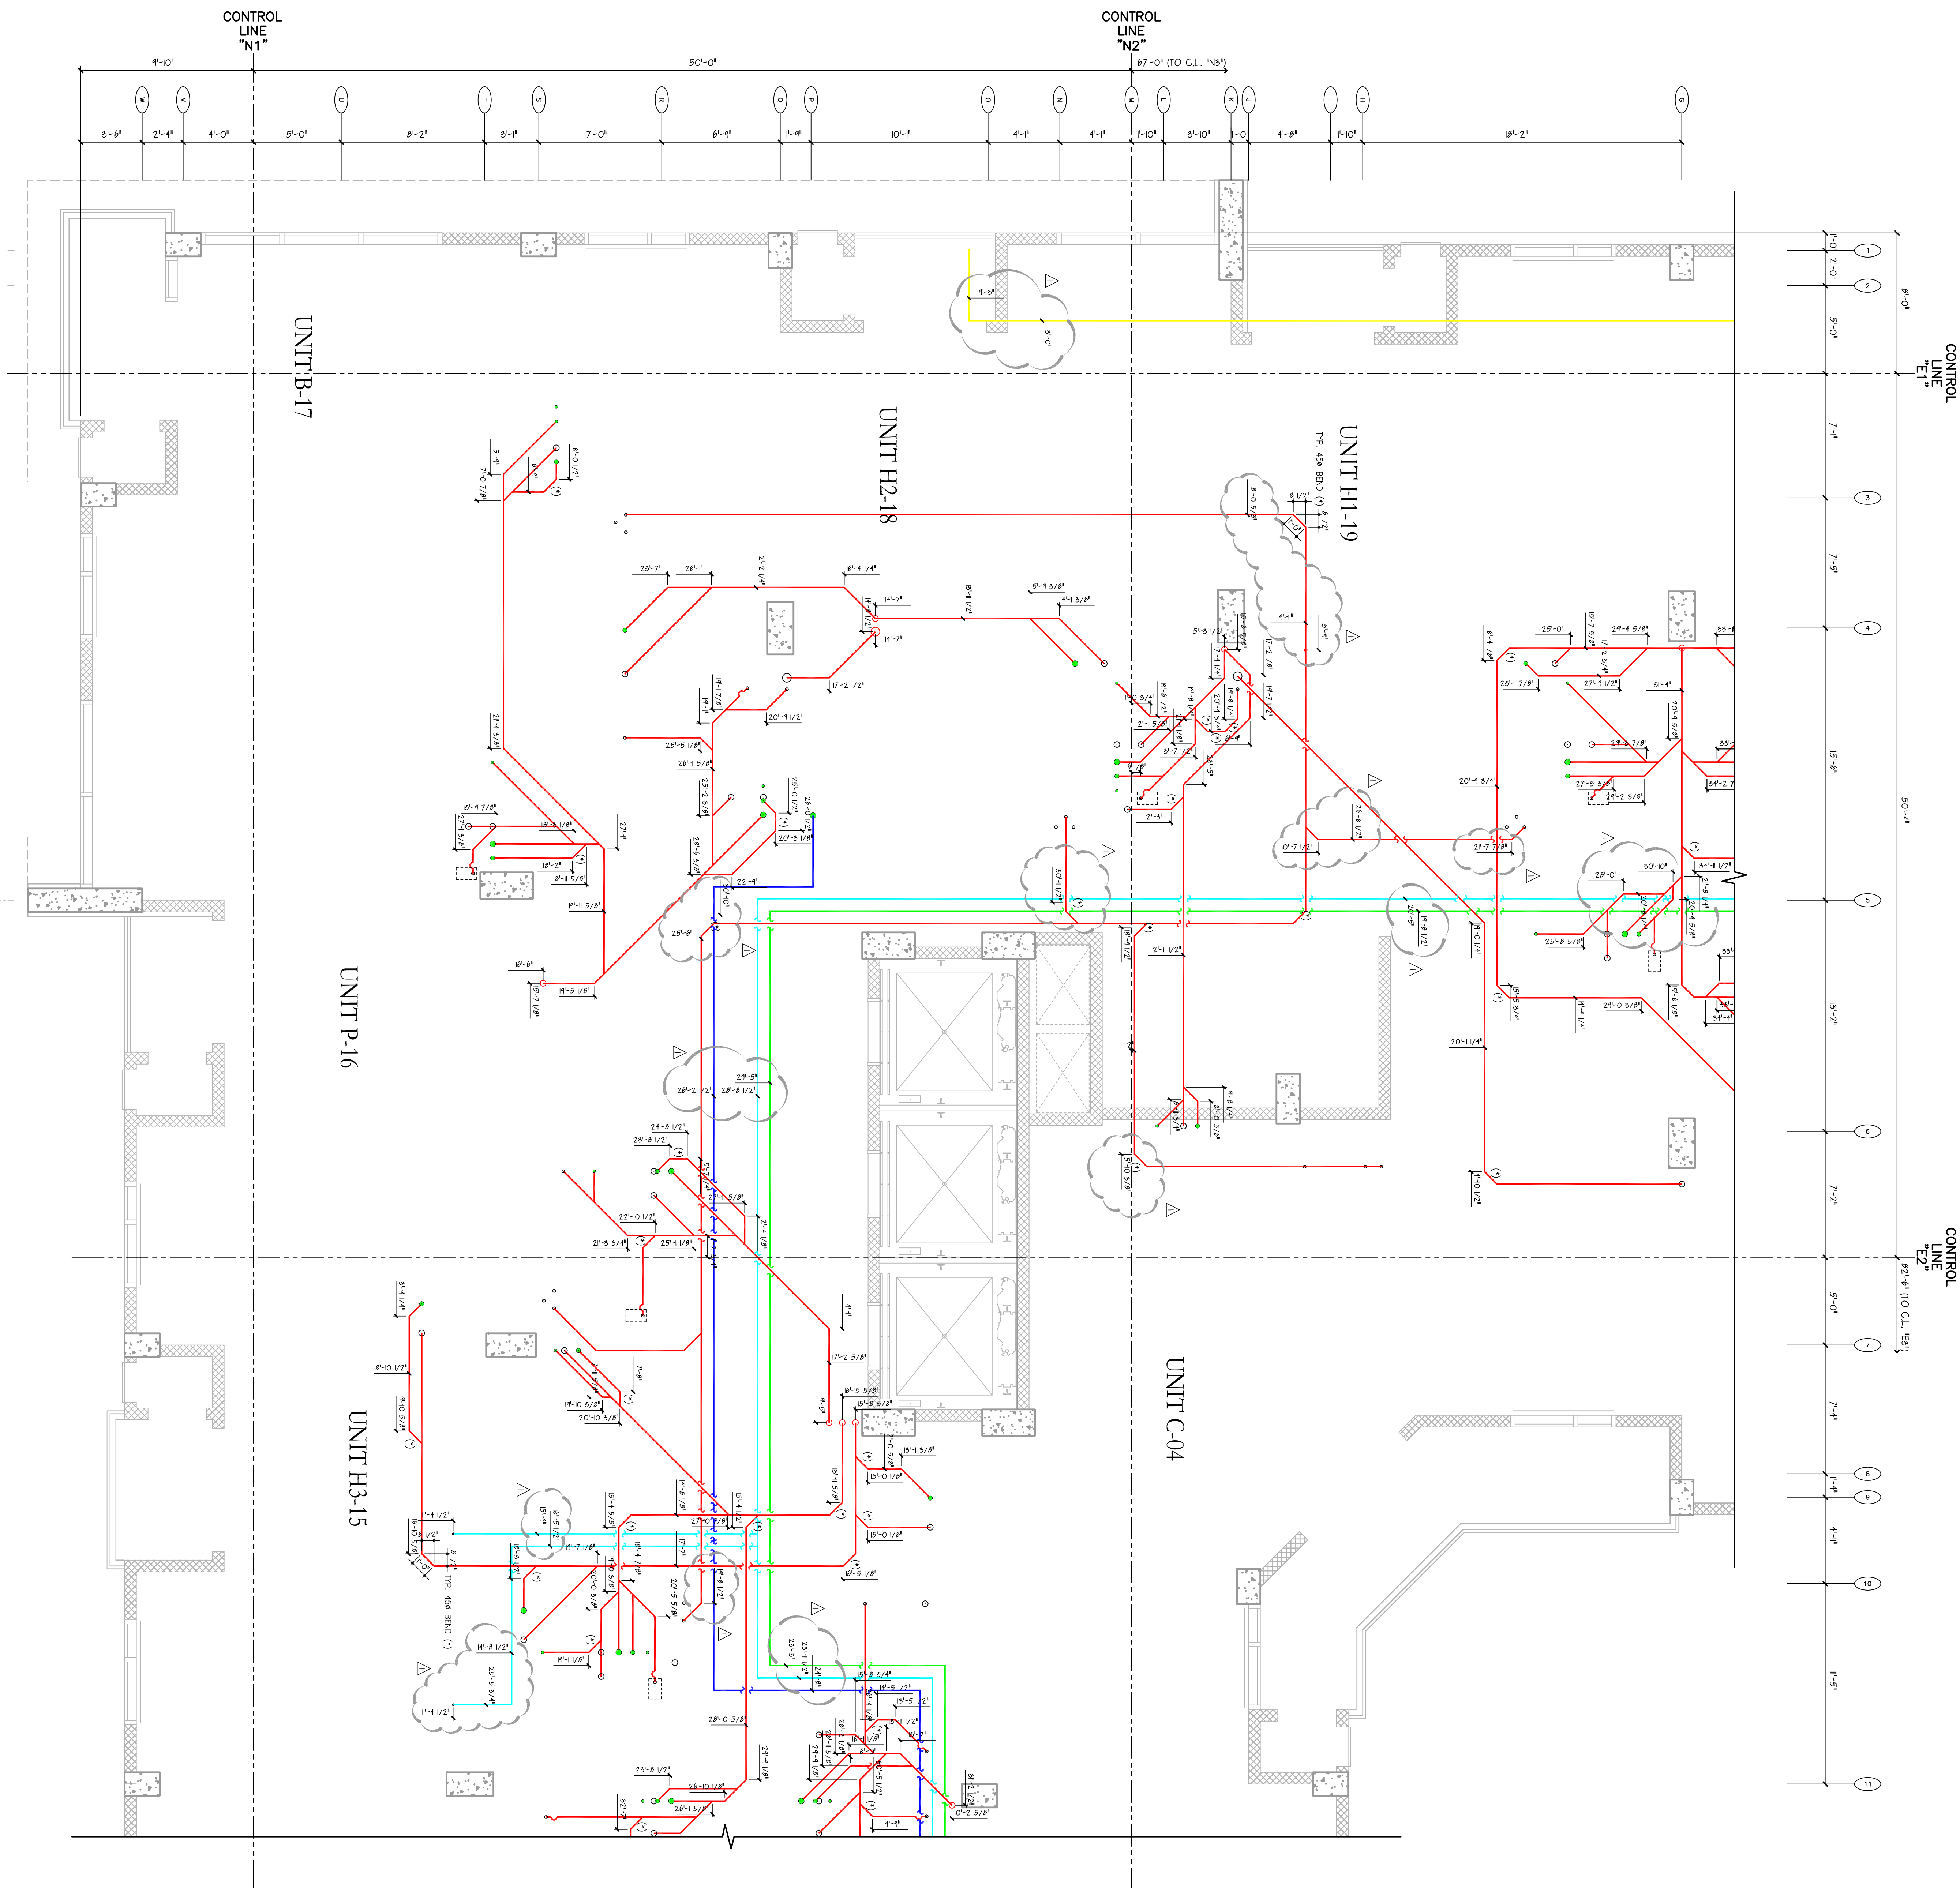

SHEET NO:	SCALE:	NO. REVISIONS:	DATE:
P3.12a	1/4"=1'-0"	ISSUED FOR FIELD USE SEE CLOUDED AREA	1/11/14 1/11/14

CLIENT:	Bears Plumbing of South Florida, Inc.
PROJECT NAME:	330 3rd Street South Residences

DRAWING TITLE:	2nd Floor Residences, West Quadrant Dimensioned Under Hang
----------------	--

Global Services  
 Brian C. Gault  
 5880  
 1800  
 1800  
 1800  
 (239) 566-8824 ph / fax  
 bpc@bearsplumbing.com