



BY	REVISIONS	DATE
P.C.G.	ISSUED FOR FIELD USE	08/22/08
P.C.G.	REVISION #1 CHANGES	08/27/08
P.C.G.	CORRECTION # SLAB STEP BACK	09/10/08

8TH LEVEL HOTEL

MASONRY WALLS
DIM'S FROM C.M.U. SLEEVES TO CONTROL LINES
STRUCTURAL
CONTROL LINES
GRID

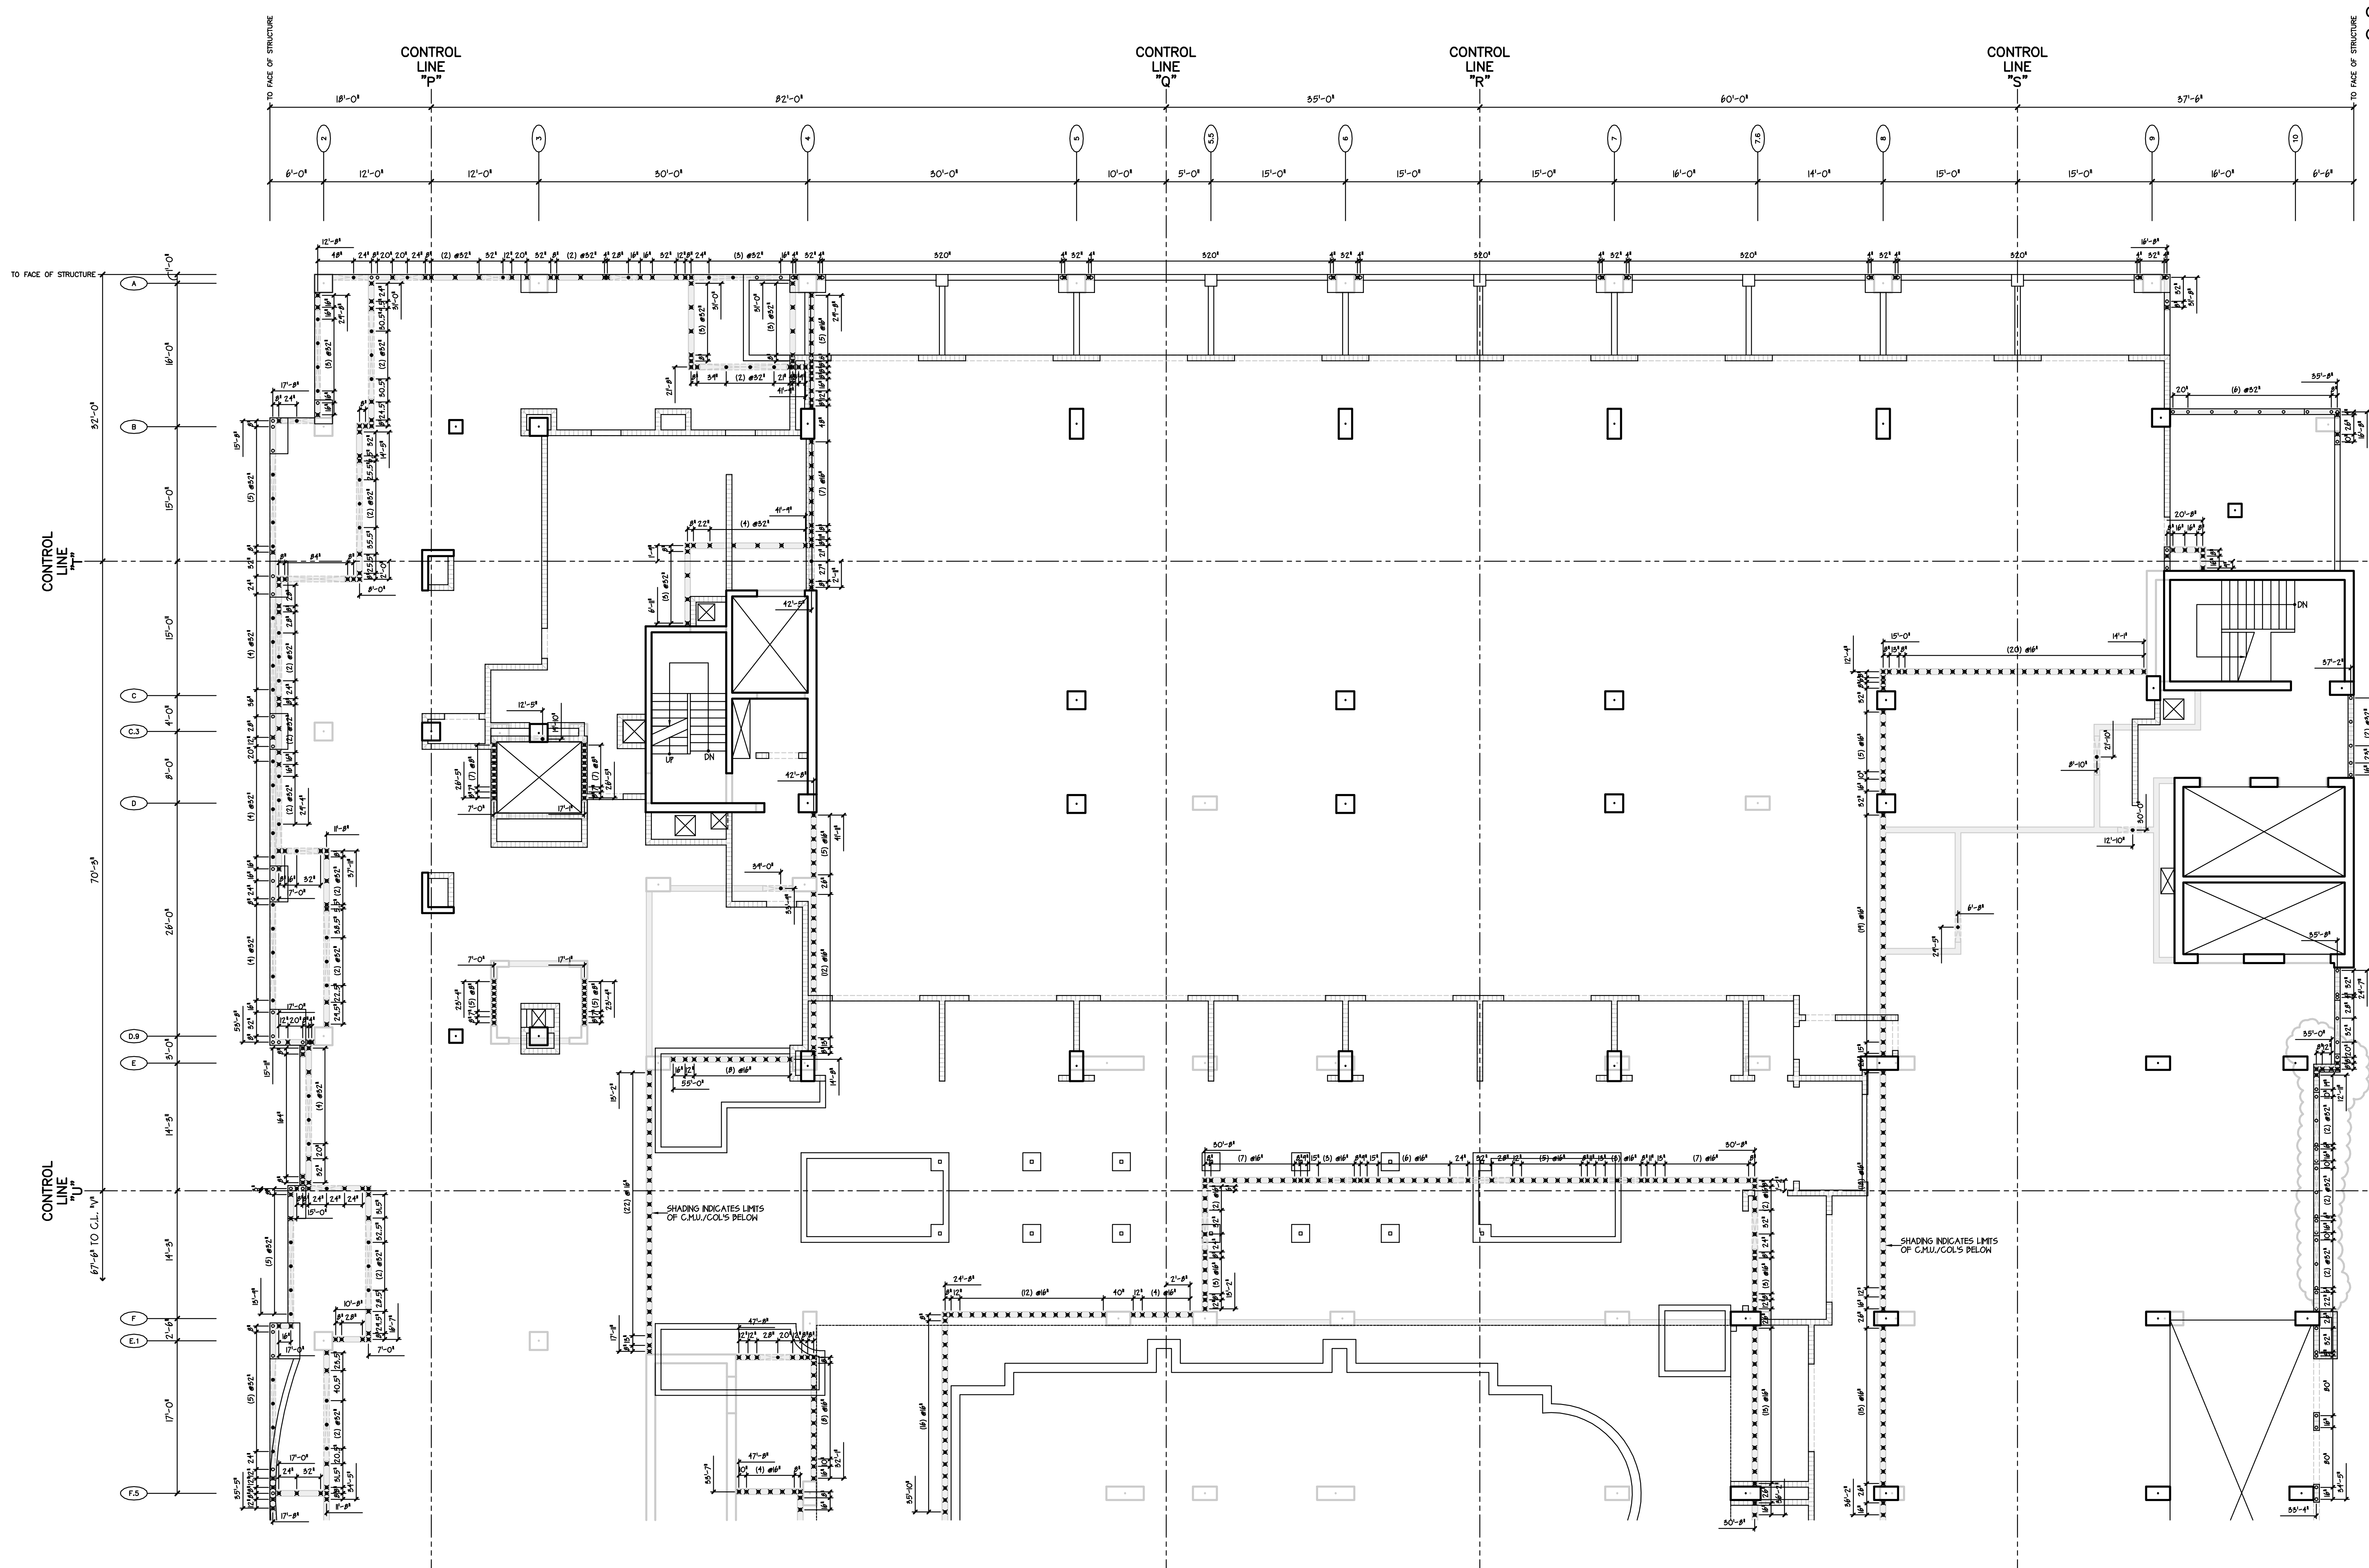

NOTES:
ALL DIMENSIONS SHOWN ARE FROM CENTERLINE OF SLEEVE PENETRATIONS PERPENDICULAR TO CONTROL LINES.
NO DONNELLS ARE REFLECTED ON THIS PLAN ONLY THROUGH SLEEVES ARE SHOWN.
REFER TO ARCHITECT OF RECORD PLANS FOR ADDITIONAL NOTES AND DETAILS.

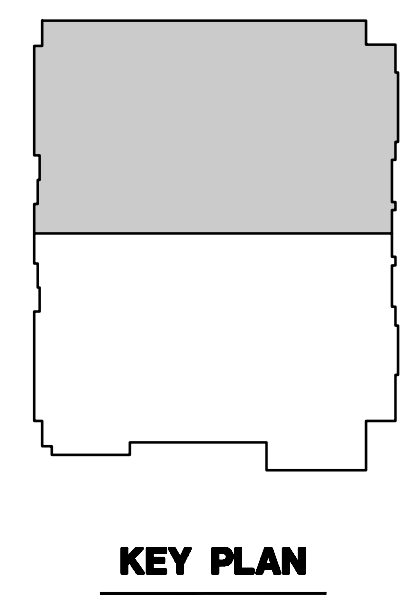

AQUALEA

NOTICE

THIS GRAPHIC PRESENTATION IS SUPPLIED WITHOUT REPRESENTATION OR WARRANTY OF ANY KIND. BRIAN C. GUHL OF A.C.I. THEREFORE ASSUMES NO RESPONSIBILITY AND SHALL HAVE NO LIABILITY, CONSEQUENTIAL OR OTHERWISE, OF ANY KIND ARISING FROM THE USE OF THESE GRAPHICS OR ANY PART THEREOF. REFERENCE SHOULD BE MADE TO THE PROJECT PLANS AND SPECIFICATIONS FOR ALL INFORMATION.

THIS SHOP DRAWING, TO AID IN THE COORDINATION OF THE PROJECT, SHALL BE SUBMITTED BY THE GENERAL CONTRACTOR TO THE VARIOUS TRADES, ENGINEERS AND ARCHITECT FOR THEIR APPROVAL.

NOT FOR CONSTRUCTION UNLESS APPROVED BY THE PROJECT ARCHITECT.
ALL DIMENSIONS AND CONDITIONS TO BE FIELD VERIFIED.
FOR VISUAL ASSISTANCE ONLY, DO NOT SCALE!

FOR CONTINUATION OF THIS AREA SEE SHEET 54.41

- DENOTES THROUGH SLEEVES UP FROM LOWER LEVEL (ITJ)
- ⊗ DENOTES SLEEVE TERMINATES AT TOP OF SLAB ELEVATION (ITJ)
- DENOTES ADD SLEEVE DOWN TO LOWER LEVEL (ITJ)

Construction Coordination Drawings	
BY: A.C.I. of S.W. FL., Inc.	
Prepared for: Bovis Lend Lease, Inc.	
Scale: 1/8"=1'-0"	Job number: 08-0107 Date: 01/07/08
Layout by: BRIAN C. GUHL	Planning by: BRIAN C. GUHL
This drawing is not to be used for construction until dimensions shown have been signed, checked and approved by the General Contractor.	
Signed: _____	Date: _____
SHEET NO.	S94.0